


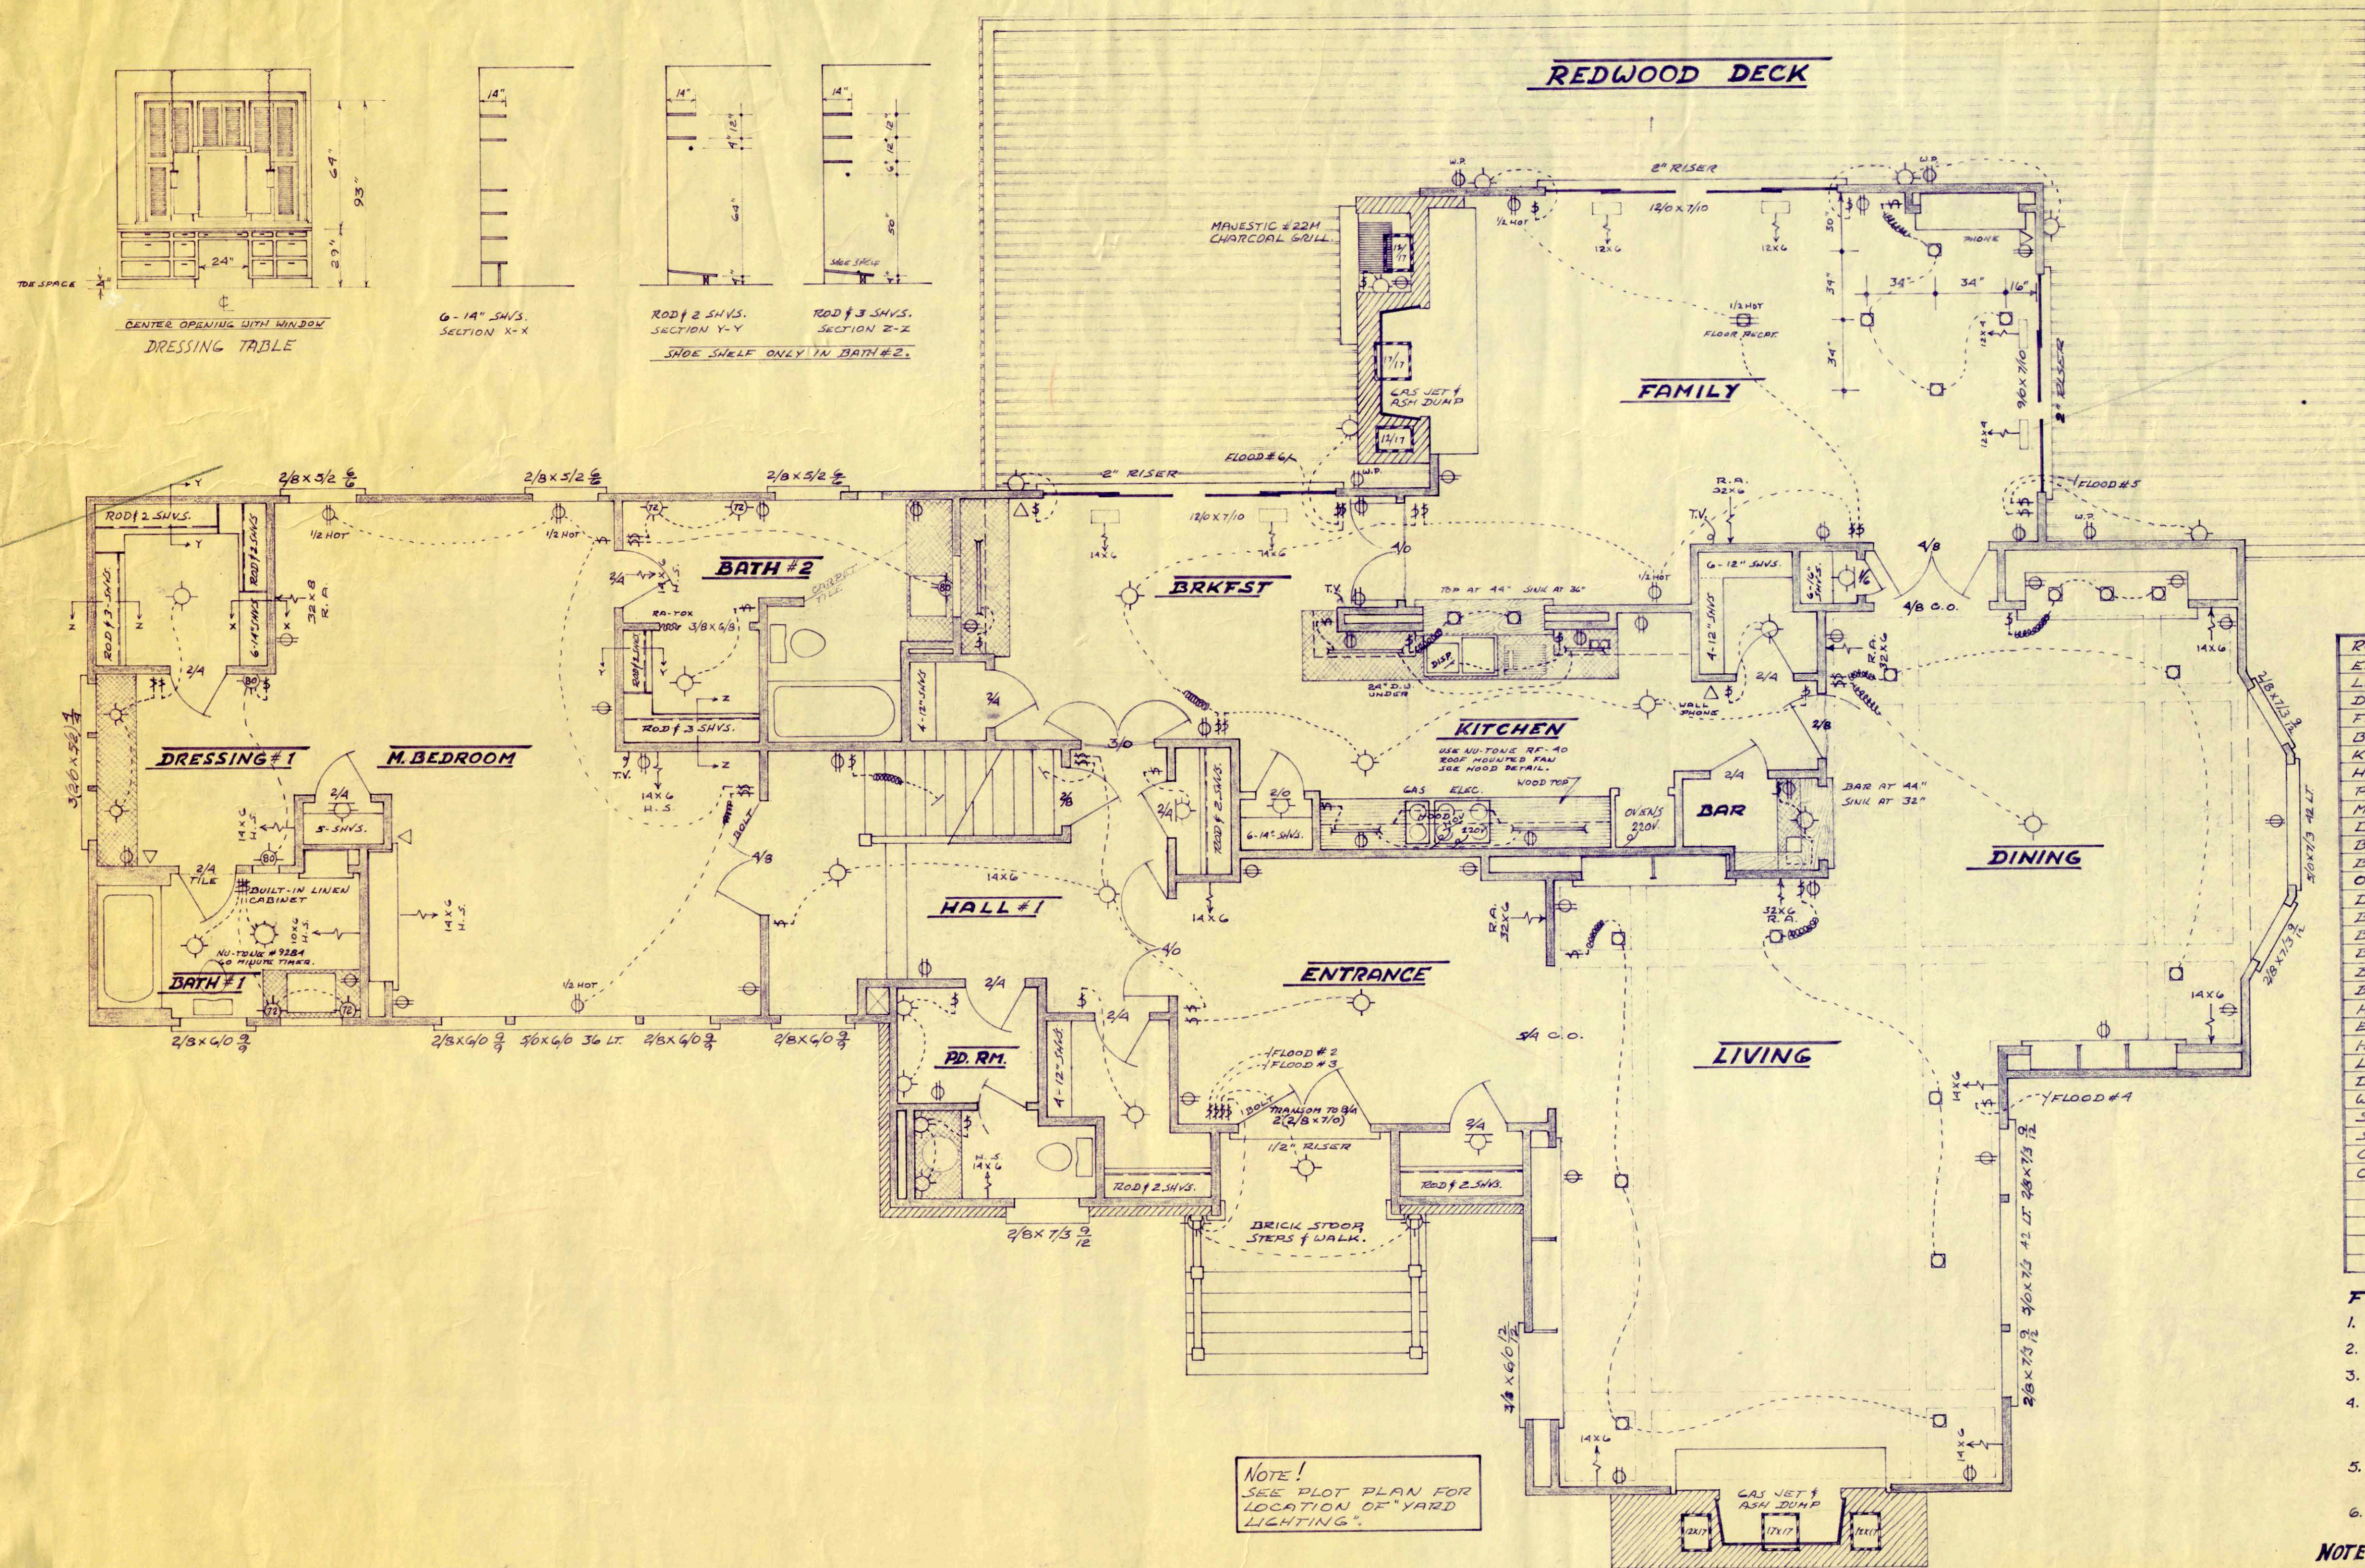

PLUMBING SCHEDULE

TUB/BRASS	LAV/BRASS	WATER CLOSET	REMARKS
KOHLER SEAFORTH 5'	19X15 MOLDED MARBLE	KOHLER K-3512 EBA	INSTALL HAND SPRAY IN LIEU OF SHOWER HEAD
MOEN TUB-SHOWER CONTROL	SPEAKMAN # S-4032 12"		* USE SPEAKMAN #1 SHOWER HEAD
KOHLER DYNAMETRIC 5 1/2'	SAME	SAME AS #1	
MOEN TUB-SHOWER CONTROL	SPEAKMAN # S-4032 12"	SAME AS #1	
3 SAME AS #1	SAME AS #2	SAME AS #1	
4 SAME AS #1	SAME AS #2	SAME AS #1	
5 SAME AS #1	SAME	SAME AS #1	
PD. ROOM	PRICE PK. MARQUEE AUTIQUE BODILIZE 12"	AHE STD # 2010.031	
KITCHEN	AHE STD SINK 43X22 # 4156, 242,	KITCHEN AID DISPOSAL # K01-110,	
BAR	ATL. CAS FAUCET 4/Spray 433.013 DRAWER	1/4" WATER LINE TO ICE-MACHINE REF.	
	ELKAY 16X18 BAR SINK, KOHLER SHOREHAM BRASS (NO SPRAY).		

FINISH SCHEDULE

ROOM OR AREA	FLOOR	BASE	DADO	CHNL	WALL	CORICE	CEILING	REMARKS
ENTRANCE	9	1	1-S	YES	GYP (1)	6" CROWN	GYP.	
LIVING	5	1	1-S	✓	(1) 1/2" BEAM	✓	NOTE CEILING BEAMS (STAINED).	
DINING	5	1	1-S	✓	(1)	✓	✓	
FAMILY	6	1	2-S	✓	WOOD (1)	6" CROWN	✓	
BRKFST	4-B	4	2-S	✓	GYP (1)	✓	✓	
KITCHEN	4-B	4	3	✓	(1)	✓	✓	
HALL #1	6	3	3	✓	(1)	✓	✓	
PD. RM.	6	3	3	✓	(1)	✓	✓	
M. BEDROOM	6	3	3	✓	(1)	✓	✓	
BEDROOM #2	6	4	5	✓	(1)	4" CROWN	✓	
BEDROOM #3	6	4	5	✓	(1)	✓	✓	
BEDROOM #4	3	NONE	NONE	✓	EXP. STD	NONE	EXP. STD.	
OFFICE	4-A	4	5	✓	GYP (1)	✓	GYP.	
DRESSING #1	6	3	3	YES	(1) 6" CROWN	✓	✓	
BATH #1	7	5	3	NO	(1) 4" CROWN	✓	✓	CERAMIC TILE TO CEILING AT TUB ONLY.
BATH #2	6/7	4	3	YES	(1)	✓	✓	
BATH #3	7	4	3	NO	(1)	✓	✓	
BATH #4	3	NONE	NONE	✓	EXP. STD	NONE	EXP. STD.	
BATH #5	4-A	4	5	✓	GYP (1)	✓	GYP.	
HALL #2	4	3	3	YES	(1) 4" CROWN	✓	✓	
ENTRY	4-A	4	2-S	✓	(1)	✓	✓	STAIRS TO BE CARPETED
HALL #3	4-A	4	2-S	✓	(1)	✓	✓	
LAUNDRY	4-A	4	5	NO	(1)	NONE	✓	
BASEMENT STOR.	2	NONE	NONE	✓	EXP. STD	✓	EXP. STD.	
WORKSHOP	2	✓	✓	✓	✓	✓	✓	
STORAGE #1	1	✓	✓	✓	✓	✓	✓	
STORAGE #2	1	✓	✓	✓	✓	✓	✓	
CARPORT	2	4	*	✓	4" CROWN	GYP.	CARPORT LINER (PAINTED).	
CLOSETS	10	4	5	✓	GYP (1)	NONE	✓	

FLOOR FINISHES:

- PLYWOOD SUB-FLOOR.
- CONCRETE ON GRADE.
- CONCRETE ON PLYWOOD.
- VINYL ON CONCRETE.
(A) ON GRADE
(B) ABOVE GRADE
- PRE-FINISHED OAK (BRUCE OLD ENGLISH) ON PLYWOOD.
- CARPET ON CONCRETE
- CERAMIC TILE ON CONCRETE (MARBLE THRESHOLD IS 1/2" HIGHER THAN FLOOR).
- QUARRY TILE ON CONCRETE.
- BRICK ON CONCRETE (LAY TIGHT JOINT).
- INDICATES SAME AS ADJOINING ROOM.

BASES:

- 9" PLAIN, NO BASEHOLD.
- 9" PLUS BASEHOLD.
- 4 1/2" PLUS BASEHOLD.
- 3 1/2" DUE MEMBER.
- CER. TILE SAUT-BASE.
- RUBBER TILE.

DADO:

- HORIZ. WOOD (RANDOM WIDTHS).
- VERT. WOOD
- VINYL ON GYP.
- PANEL MOLDS.
- PAINTED GYP.

WALL:

- PAINTED GYP.
- VINYL ON GYP.
- STAINED WOOD.

NOTE!

WHERE 9" BASE IS INDICATED INSTALL HEAT REGISTERS & ELEC. RECPRT. ON BASEBOARD.


DOORS - 6 PANEL COLONIAL UNLESS INDICATED OTHERWISE.



S-INDICATES STAINED P-PAINT.

FIRST FLOOR PLAN

HEATING
ELECTRICAL
PLUMBING
MILLWORK
1/4 SCALE


REVISED 4/1/73

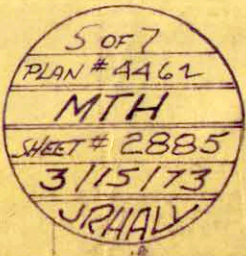

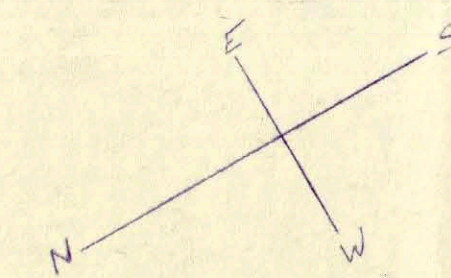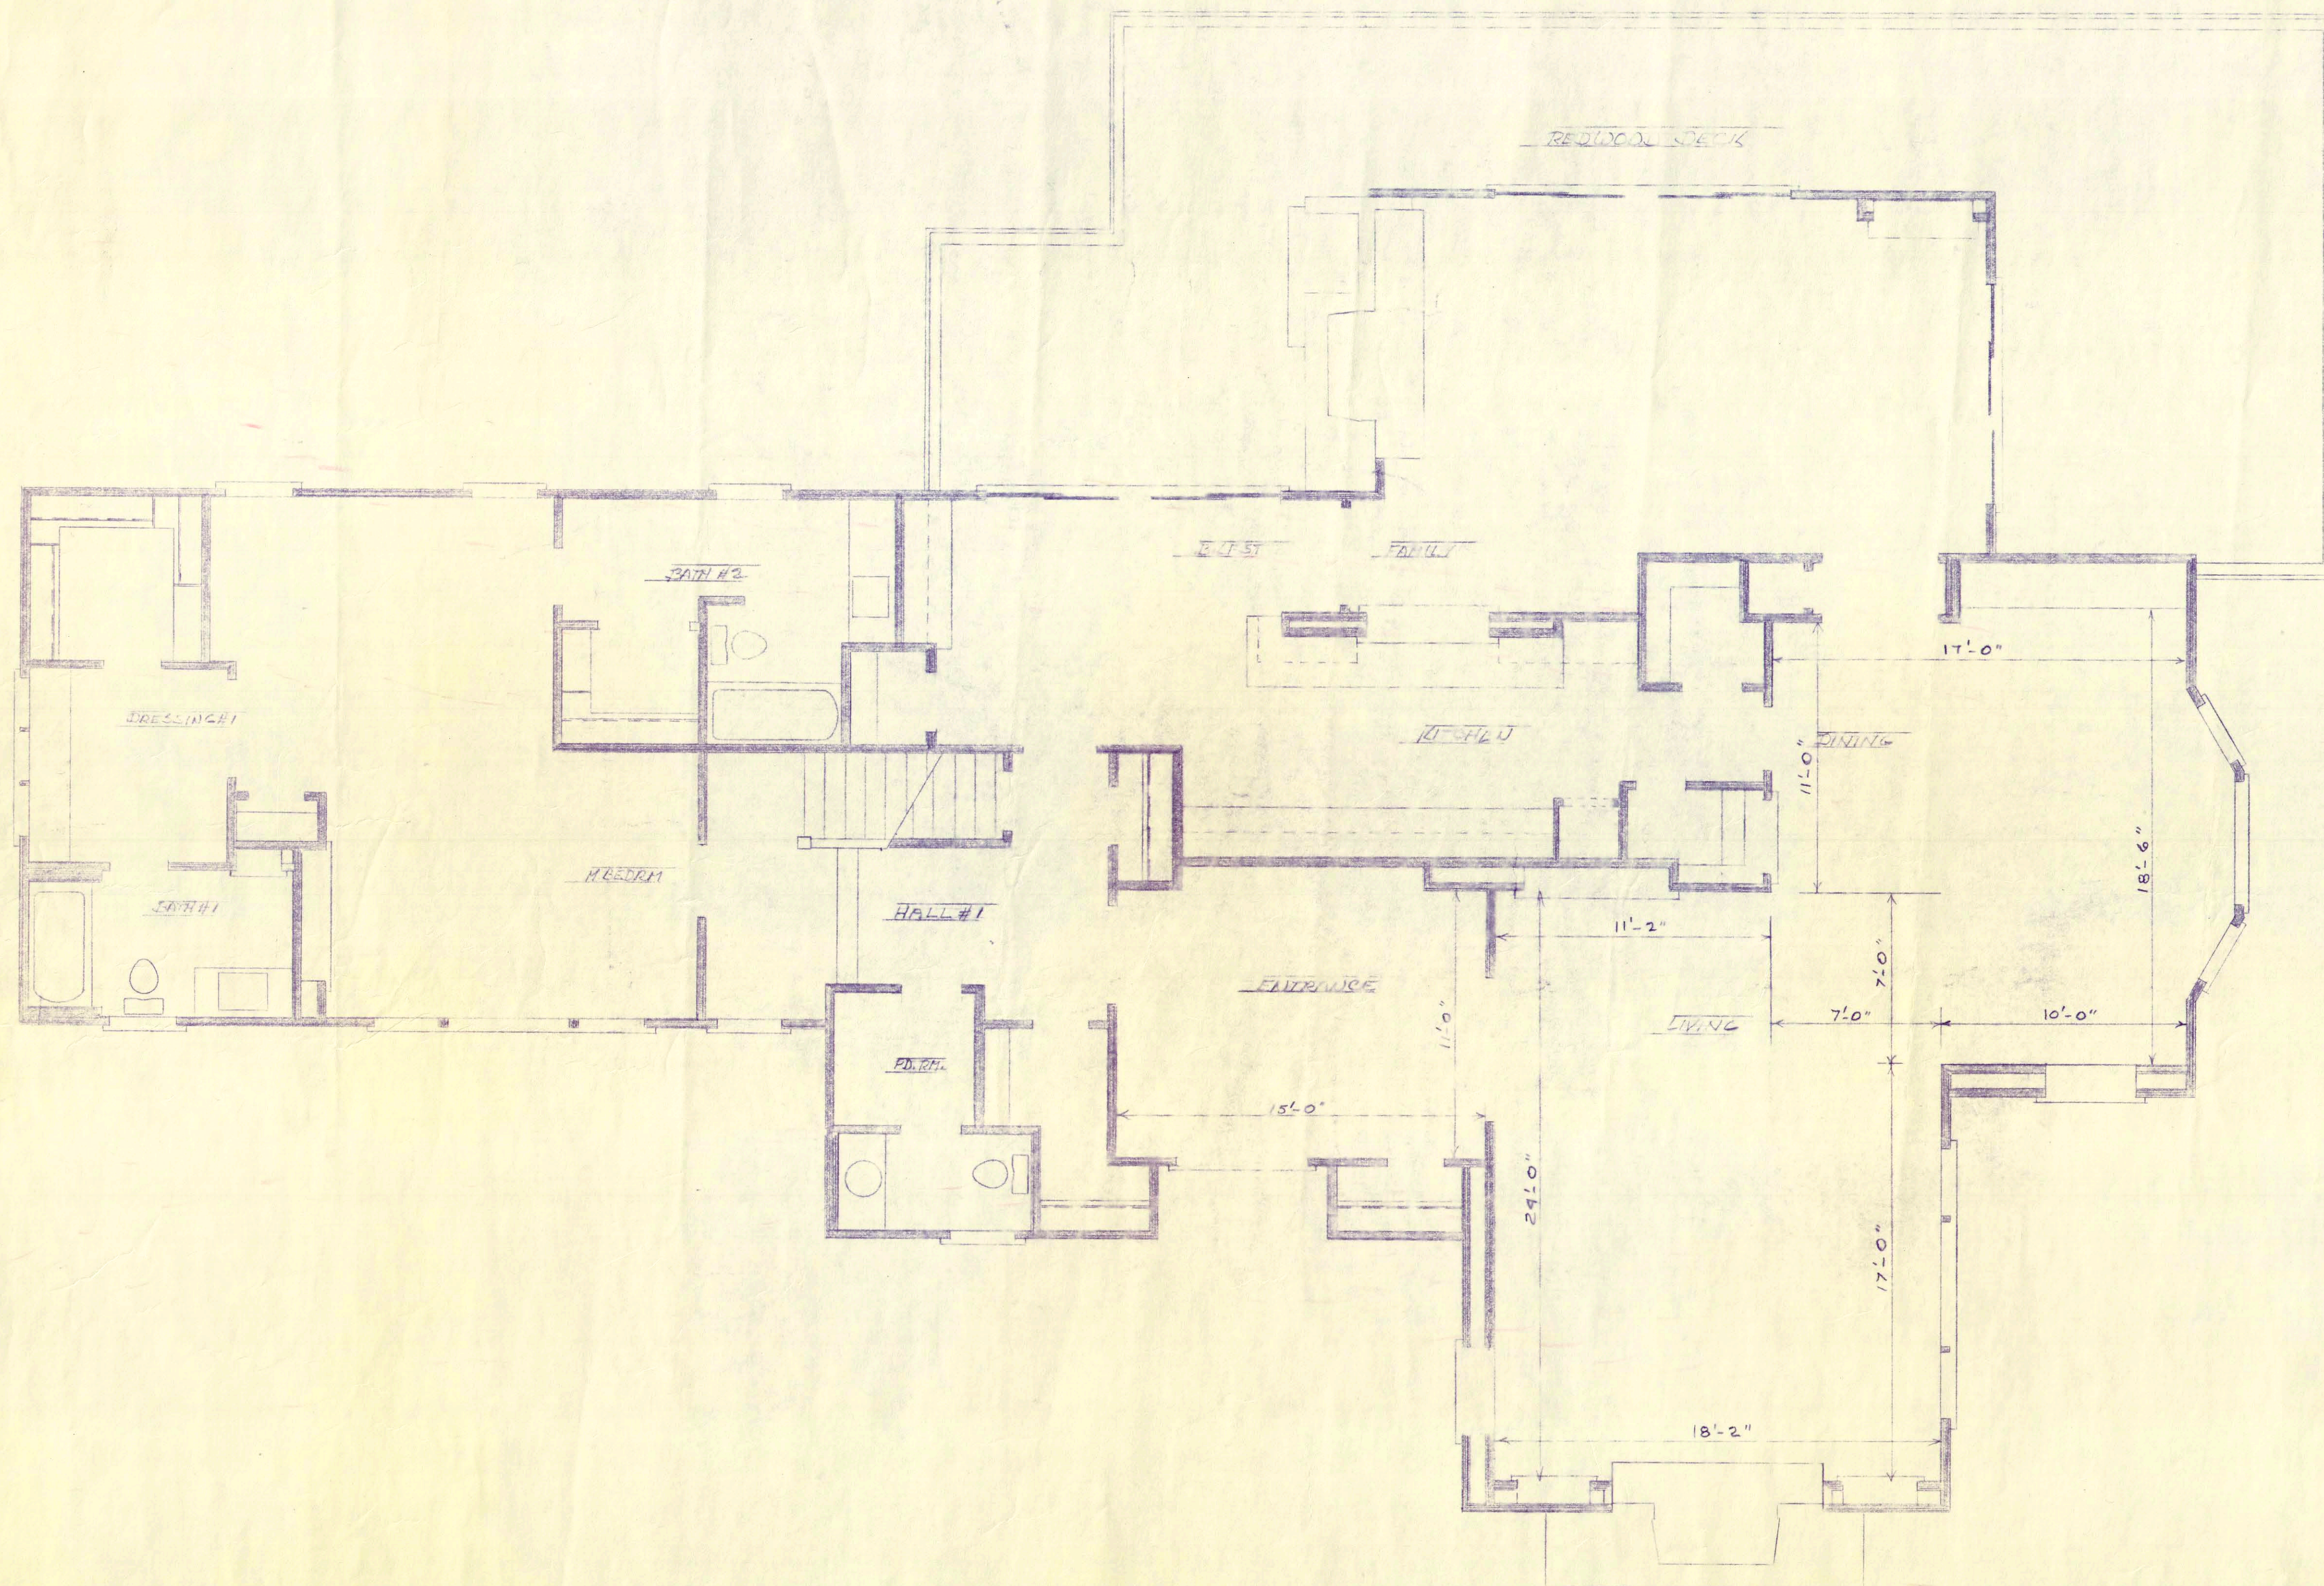

4041 RANDALL MILL
FIRST FLOOR

SCALE 1/4" = 1'-0"

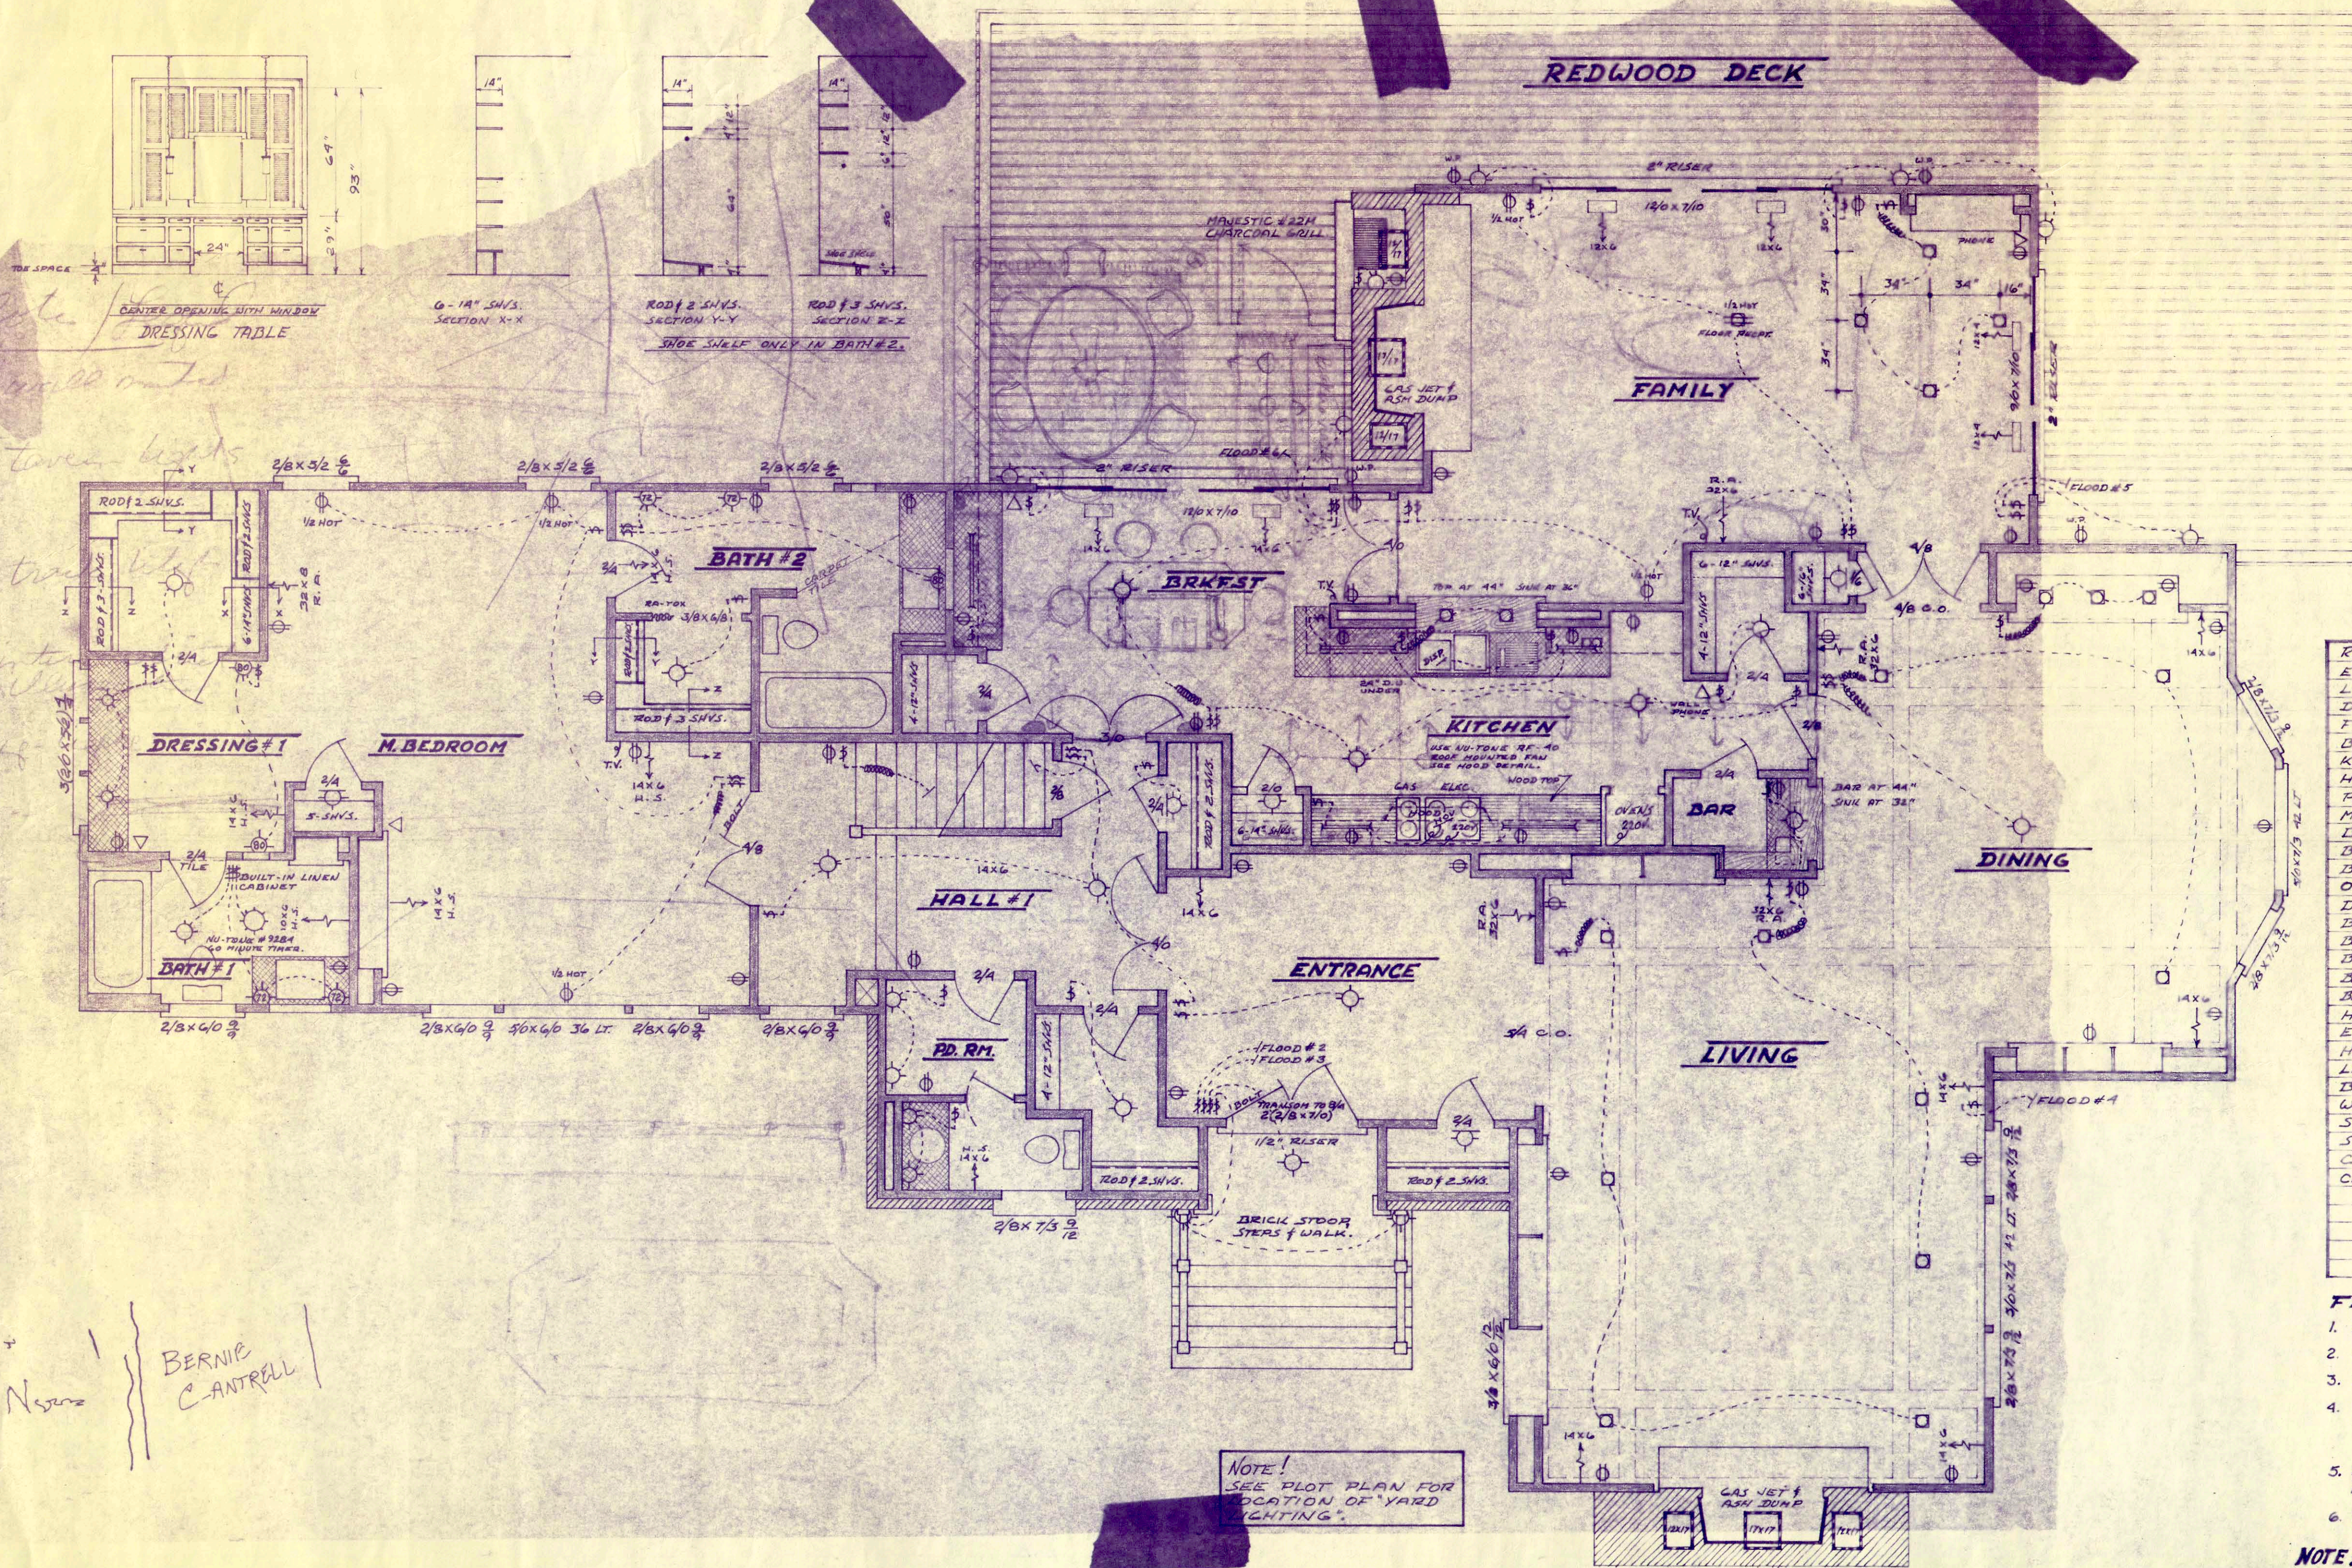

PLUMBING SCHEDULE

TUB/BRASS	LAV/BRASS	WATER CLOSET	REMARKS
1. KOHLER SEAFOOTH-S' NOHEN TUB-SHOULDR CONTROL	1. 10x15 MOLDDED MARBLE SPEAKMAN # 5-4032 12"	KOHLER K-3572 EBA	INSTALL HAND SPRAY IN LIEU OF SHOWER HEAD
2. KOHLER DYNAMIC-57/2 NOHEN TUB-SHOULDR CONTROL	SAME SPEAKMAN # 5-4032 12"	SAME AS #1	* USE SPEAKMAN #1 SHOWER HEAD
3. SAME AS #1	SAME AS #2	12"	SAME AS #1
4. SAME AS #1	SAME AS #2	12"	SAME AS #1
5. SAME AS #1	SAME SPEAKMAN # 5-4062 4"	SAME AS #1	
PD. ROOM	SAME PRICE PF. MARQUIS ANTIQUE BRONZE 12"	AME STD # 2010.031	
KITCHEN	AME STD SINK 43X22 # 6256.242, AITZ GAS FAUCET 45949 431.013 DRAINER	1/4" WATER LINE TO ICE-MAKER REF.	
BAR	ELKAY 16 X 18 BAR SINK, KOHLER SHOWERHAM BRASS (NO SPRAY)		

FINISH SCHEDULE

ROOM OR AREA	FLOOR	BASE	DADO	WALL	CORVICE	CEILING	REMARKS
ENTRANCE	9	1	1-5	YES	GYP (1)	GYP	
LIVING	5	1	1-5	YES	6" CROWN	GYP	NOTE CEILING BEAMS (STAINED).
DINING	5	1	1-5	YES	6" CROWN	GYP	
FAMILY	6	1	2-5	YES	WOOD 6" CROWN	GYP	
BRKFST	4-B	4	2-5	YES	GYP (1)	GYP	
KITCHEN	4-B	4	3	YES	GYP (1)	GYP	
HALL #1	6	3	3	YES	6" CROWN	GYP	
PD. RM.	6	3	5	YES	6" CROWN	GYP	
M. BEDROOM	6	3	3	YES	6" CROWN	GYP	
BEDROOM #2	6	4	5	NO	4" CROWN	GYP	
BEDROOM #3	6	4	5	YES	6" CROWN	GYP	
BED ROOM #4	3	NONE	NONE	EXP. STUB	NONE	EXP. STUB	
OFFICE	4-A	4	5	YES	GYP (1)	GYP	
DRESSING #1	6	3	3	YES	6" CROWN	GYP	
BATH #1	7	5	3	NO	4" CROWN	GYP	CERAMIC TILE TO CEILING AT TUB ONLY
BATH #2	6/7	4	3	YES	6" CROWN	GYP	
BATH #3	7	4	3	NO	4" CROWN	GYP	
BATH #4	3	NONE	NONE	EXP. STUB	NONE	EXP. STUB	
BATH #5	4-A	4	5	YES	GYP (1)	GYP	
HALL #2	6	3	3	YES	6" CROWN	GYP	
ENTRY	4-A	4	2-5	YES	6" CROWN	GYP	STAIRS TO BE CARPETED
HALL #3	4-A	4	2-5	YES	6" CROWN	GYP	
LAUNDRY	4-A	4	5	NO	4" CROWN	GYP	
BASEMENT STOR.	2	NONE	NONE	EXP. STUB	NONE	EXP. STUB	
WORKSHOP	2	1	1	YES	GYP	GYP	
STORAGE #1	1	1	1	YES	GYP	GYP	
STORAGE #2	1	1	1	YES	GYP	GYP	
CARPORT	2	4	*	YES	4" CROWN	GYP	CARPORT LINER (PAINTED).
CLOSETS	10	4	5	YES	GYP (1)	NONE	

FLOOR FINISHES:

- PLYWOOD SUB-FLOOR.
- CONCRETE ON GRADE.
- CONCRETE ON PLYWOOD.
- VINYL ON CONCRETE.
(a) ON GRADE
(b) ABOVE GRADE
- PRE-FINISHED OAK (BRUCE OLD ENGLISH) ON PLYWOOD.
- CARPET ON CONCRETE

BASES:

- 9" PLAIN, NO BASEMOLD.
- 9" PLUS BASEMOLD.
- 4 1/2" PLUS BASEMOLD.
- 3 1/2" DUE MEMBER.
- CER. TILE SANI-BASE.
- RUBBER TILE.

WALL:

- PAINTED GYP.
- VINYL ON GYP.
- STAINED WOOD.

DADO:

- HORIZ. WOOD (RANDOM WIDTHS).
- VERT. WOOD
- VINYL ON GYP.
- PANEL MOLDS.
- PAINTED GYP.

NOTE!

WHERE 9" BASE IS INDICATED INSTALL HEAT REGISTERS & ELEC. RECEPT ON BASEBOARD.


DOORS-6 PANEL COLONIAL UNLESS INDICATED OTHERWISE.


FIRST FLOOR PLAN

HEATING
ELECTRICAL
PLUMBING
MILLWORK

1/4" SCALE

REVISED 4/1/73

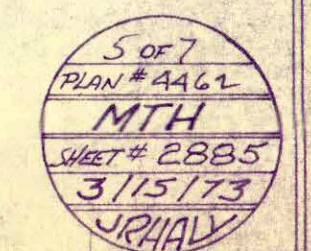


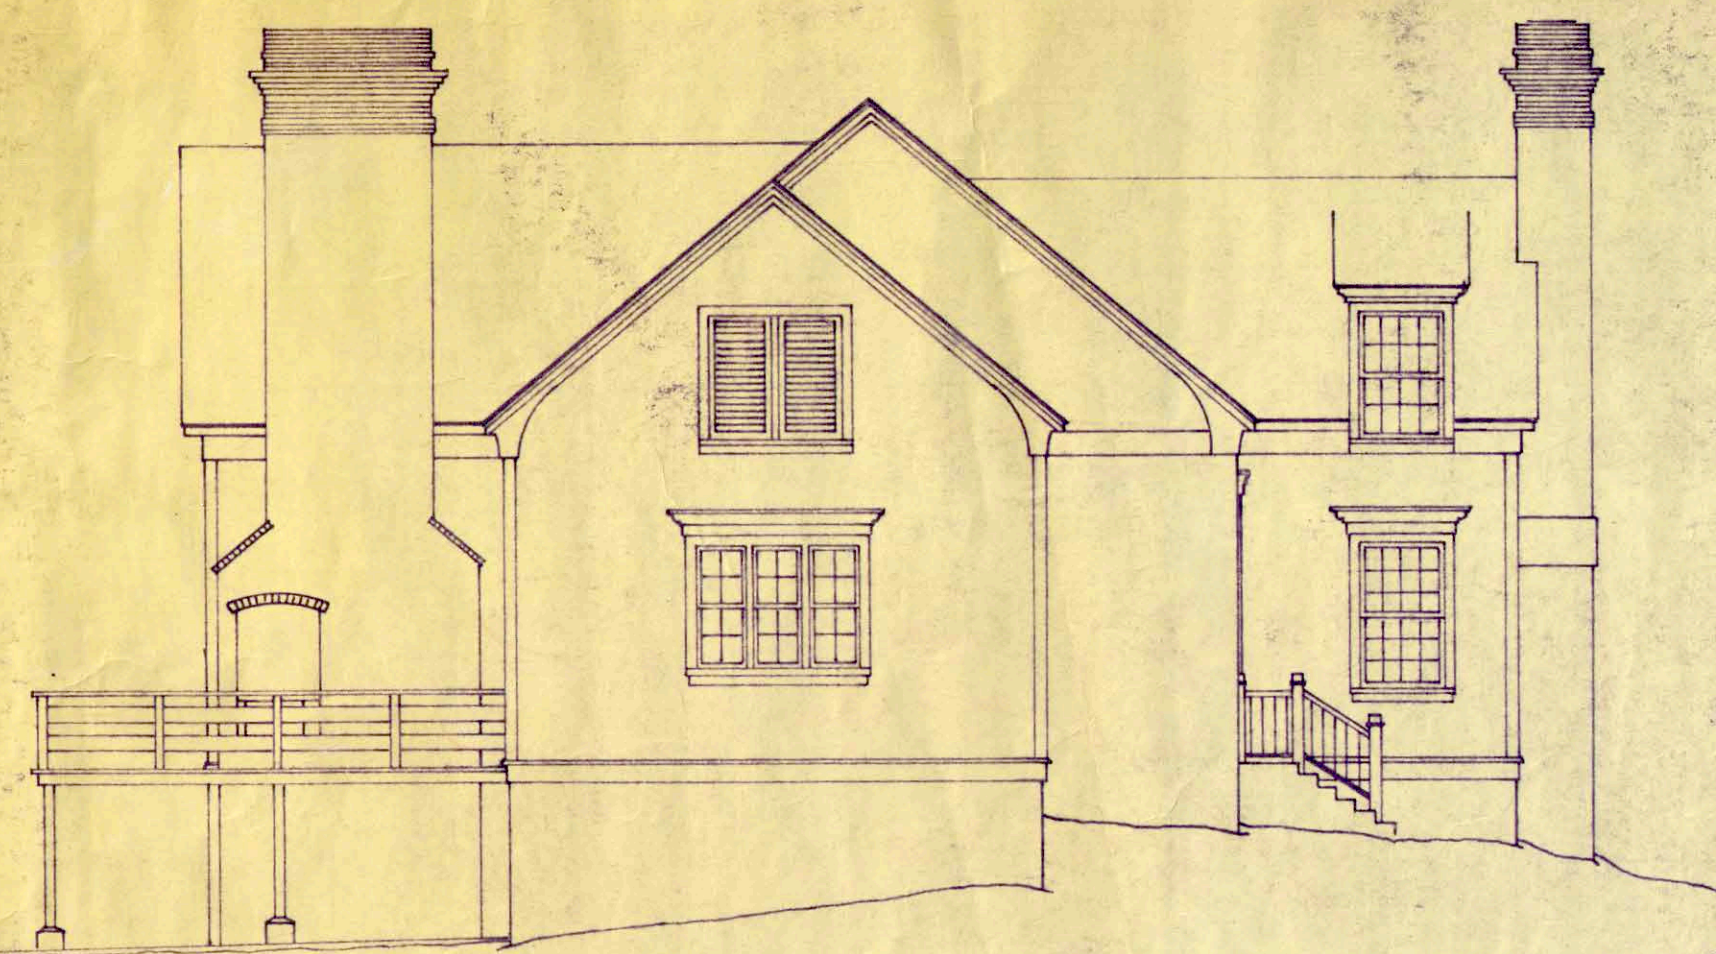

LEFT



REAR

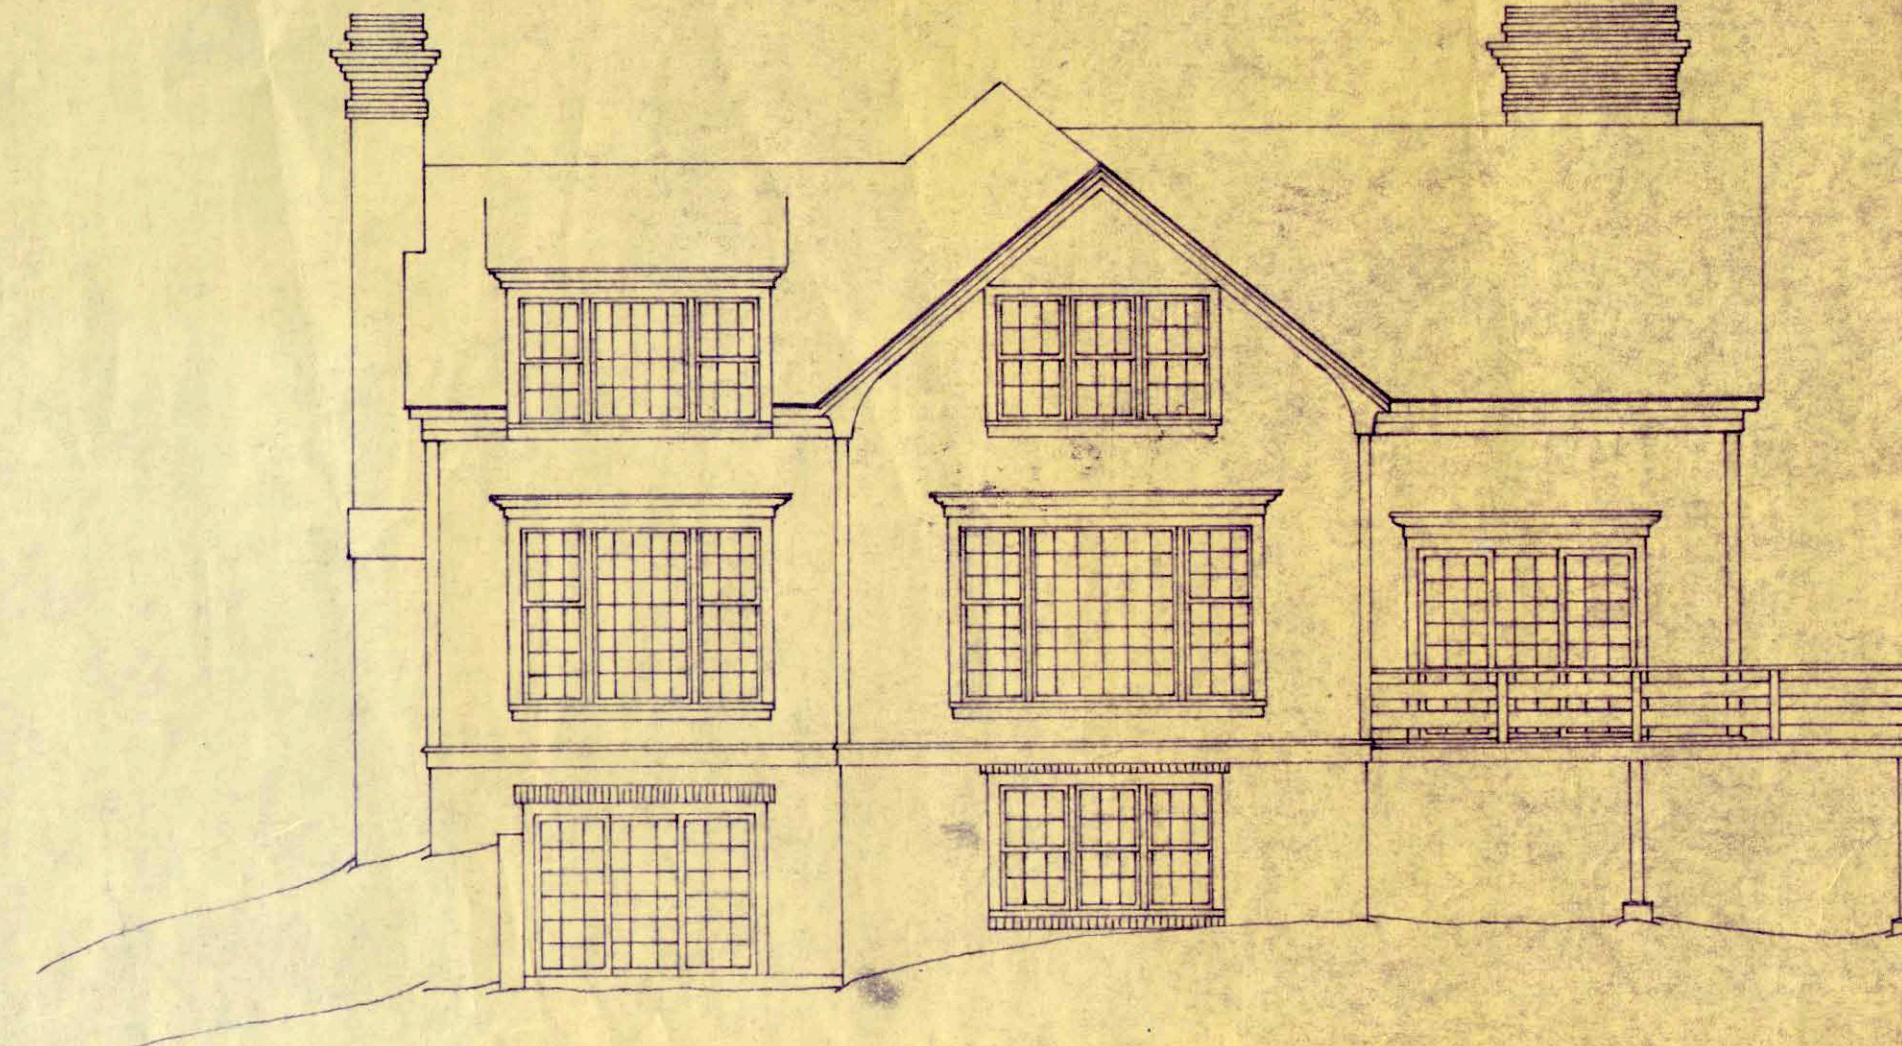



RIGHT



FRONT

BARRETT "SHADOW BLACK"
245 # CORR. SHINGLE. LAY
FROM LEFT TO RIGHT.

ELEVATIONS

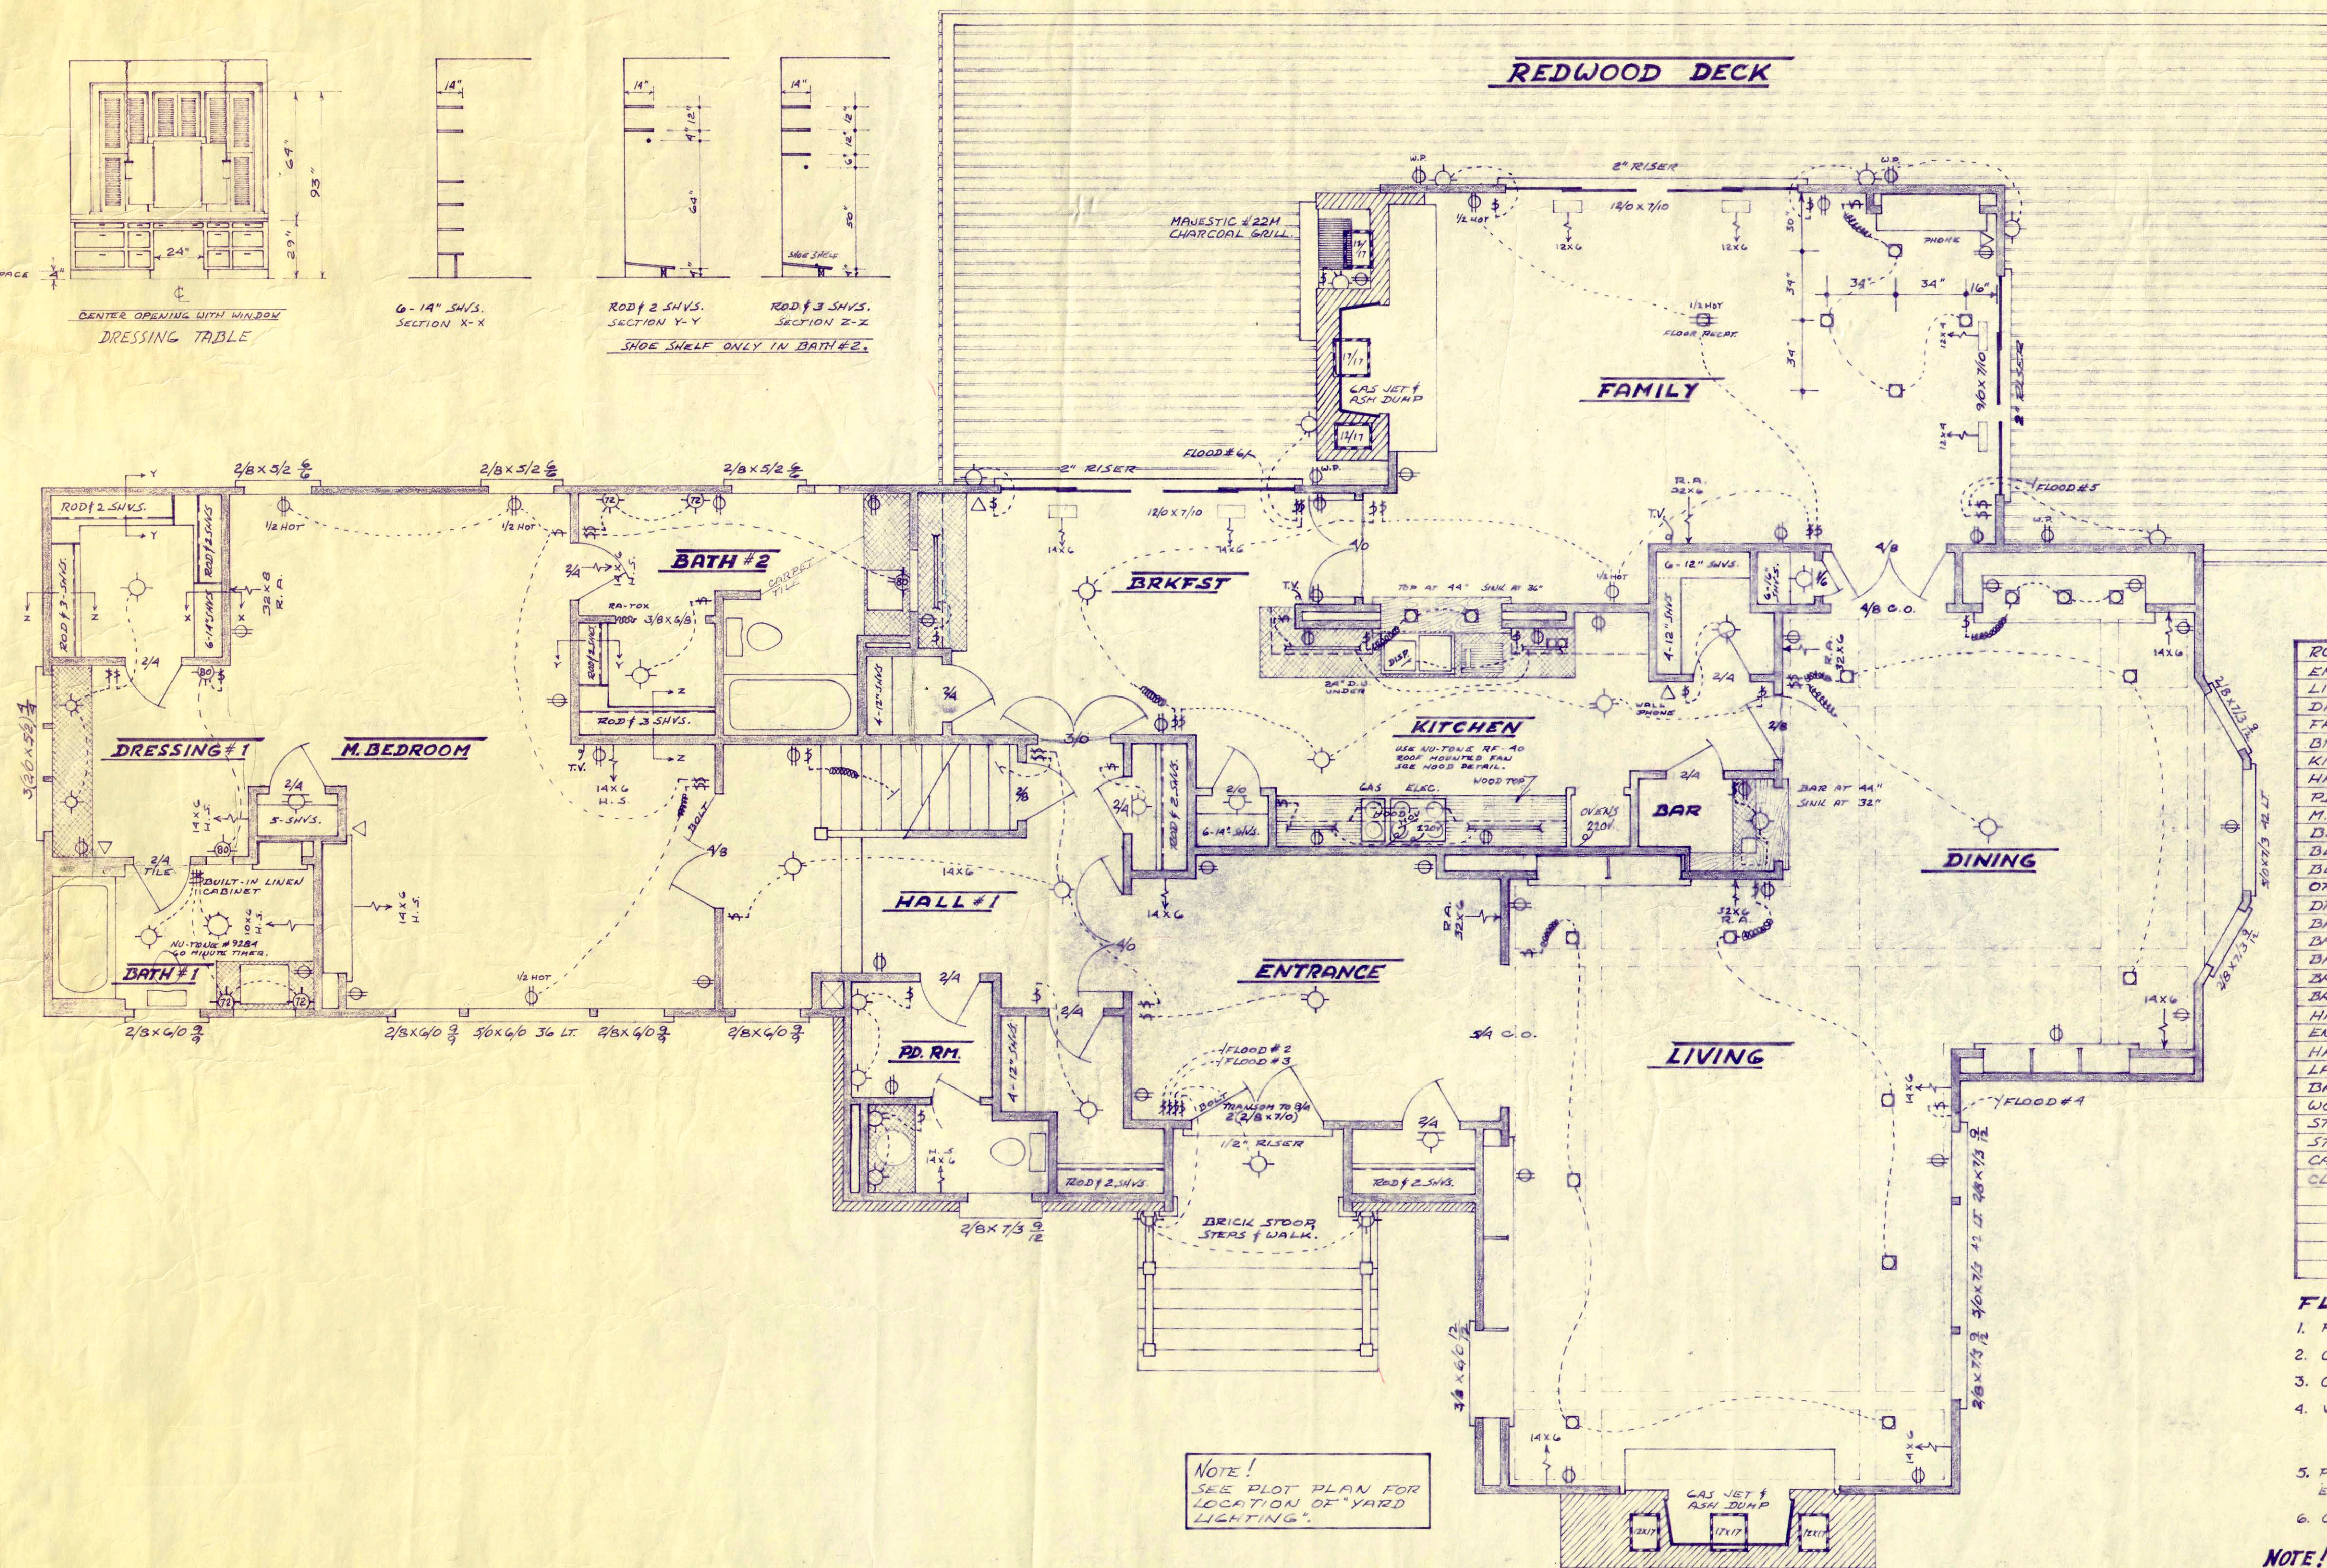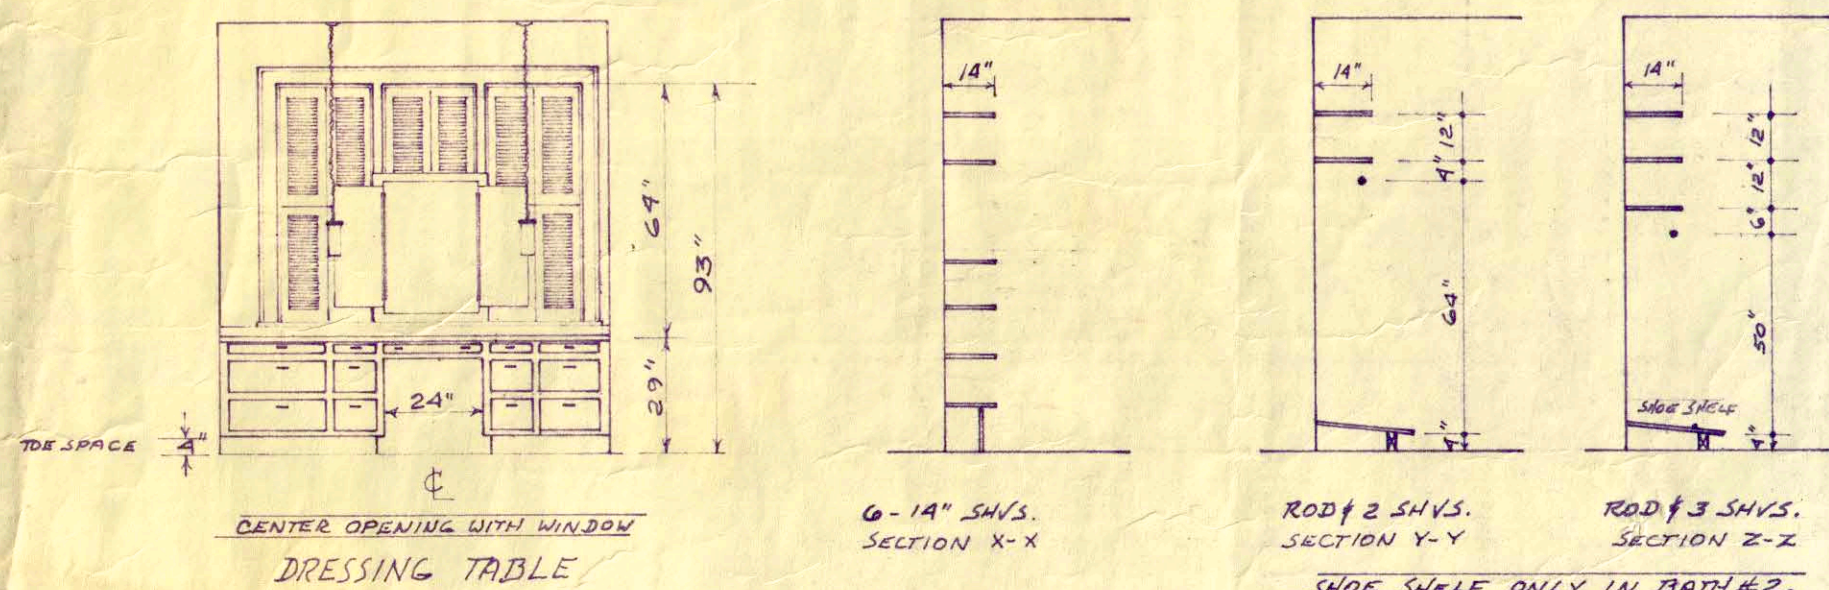

PLUMBING SCHEDULE

TUB/BRASS	LAVI/BRASS	WATER CLOSET	REMARKS
1 KOHLER SEAFORTH-5' MOEN TUB-SHOWER CONTROL	19X15 MOLDED MARBLE SINKMAN # S-4032 12"	KOHLER K-3512 EBA	INSTALL H. IN LIEU OF * USE SPET. SHOWER
2 KOHLER DYNAMETRIC-5 1/2" MOEN TUB-SHOWER CONTROL	SAME SINKMAN # S-4032 12"	SAME AS #1	
3 SAME AS #1	SAME AS #2	12"	SAME AS #1
4 SAME AS #1	SAME AS #2	12"	SAME AS #1
5 SAME AS #1	SAME SINKMAN # S-4062 4"	SAME AS #1	
PD. ROOM	PRICE PK. MARQUIS ANTIQUE BRONZE 12"	AME. STD # 2010.031	
KITCHEN	AME. STD. SINK 43X22 # 2256.342, 1/4" WATER LINE TO ICE-MAKER REF.	KITCHEN AID DISPOSAL # KLU-110, 1/4" WATER LINE TO ICE-MAKER REF.	
BAR	ELIKAY 16X18 BAR-SINK, KOHLER SHOREHAM BRASS (NO SPRAY)		

FINISH SCHEDULE

ROOM OR AREA	FLOOR	BASE	DADO	WALL	CORNICIE	CEILING	REMARKS
ENTRANCE	9	1	1-S	YES	GYP (1)	GYP.	
LIVING	5	1	1-S	✓	1/2" DEAM	✓	NOTE CEILING BEAMS (ST)
DINING	5	1	1-S	✓	1/2" DEAM	✓	
FAMILY	6	1	2-S	✓	WOOD 6" CROWN	✓	
BRKFST	4-B	4	2-S	✓	GYP (1)	✓	
KITCHEN	4-B	4	3	✓	1/2" DEAM	✓	
HALL #1	6	3	3	✓	1/2" DEAM	✓	
PD. RM.	6	3	5	✓	1/2" DEAM	✓	
M. BEDROOM	6	3	3	✓	1/2" DEAM	✓	
BEDROOM #2	6	4	5	NO	1/2" DEAM	✓	
BEDROOM #3	6	4	5	✓	1/2" DEAM	✓	
BEDROOM #4	3	NONE	NONE	✓	EXP. STD	NONE	EXP. STD.
OFFICE	4-A	4	5	✓	GYP (1)	✓	
DRESSING #1	6	3	3	YES	1/2" DEAM	✓	
BATH #1	7	5	3	NO	1/2" DEAM	✓	CERAMIC TILE TO CEILING
BATH #2	6/7	4	3	YES	1/2" DEAM	✓	
BATH #3	7	4	3	NO	1/2" DEAM	✓	
BATH #4	3	NONE	NONE	✓	EXP. STD	NONE	EXP. STD.
BATH #5	4-A	4	5	✓	GYP (1)	✓	
HALL #2	6	3	3	YES	1/2" DEAM	✓	
ENTRY	4-A	4	2-S	✓	1/2" DEAM	✓	STAIRS TO BE CARP.
HALL #3	4-A	4	2-S	✓	1/2" DEAM	✓	
LAUNDRY	4-A	4	5	NO	1/2" DEAM	✓	
BASEMET. STOR.	2	NONE	NONE	✓	EXP. STD	✓	EXP. STD.
WORKSHOP	2	✓	✓	✓	✓	✓	
STORAGE #1	1	✓	✓	✓	✓	✓	
STORAGE #2	1	✓	✓	✓	✓	✓	
CARPORT	2	4	*	✓	1/2" DEAM	GYP.	CARPORT LINER (S)
CLOSETS	10	4	5	✓	GYP (1)	NONE	✓

FLOOR FINISHES:

- PLYWOOD SUB-FLOOR.
- CONCRETE ON GRADE.
- CONCRETE ON PLYWOOD.
- VINYL ON CONCRETE. (A) ON GRADE (B) ABOVE GRADE
- PRE-FINISHED OAK (BRUCE OLD ENGLISH) ON PLYWOOD.
- CARPET ON CONCRETE
- CERAMIC TILE ON CONCRETE (MARBLE THRESHOLD IS 1/2" HIGHER THAN FLOOR).
- QUARRY TILE ON CONCRETE.
- BRICK ON CONCRETE (LAY TIGHT JOINT).
- INDICATES SAME AS ADJOINING ROOM.

NOTE!

WHERE 9" BASE IS INDICATED INSTALL HEAT REGISTERS & ELEC. RECEPT. ON BASEBOARD.

DOORS - 6 PANEL COLONIAL UNLESS INDICATED OTHERWISE.


DADO:

- HORIZ. WOOD (RANDOM WIDTHS).
- VERT. WOOD
- VINYL ON GYP.
- PANEL MOLDS.
- PAINTED GYP.

S-INDICATES STAINED P=PAINT.

FIRST
HEATING
ELECTRICAL
PLUMBING
MILLWORK

REVISED 4/1/73

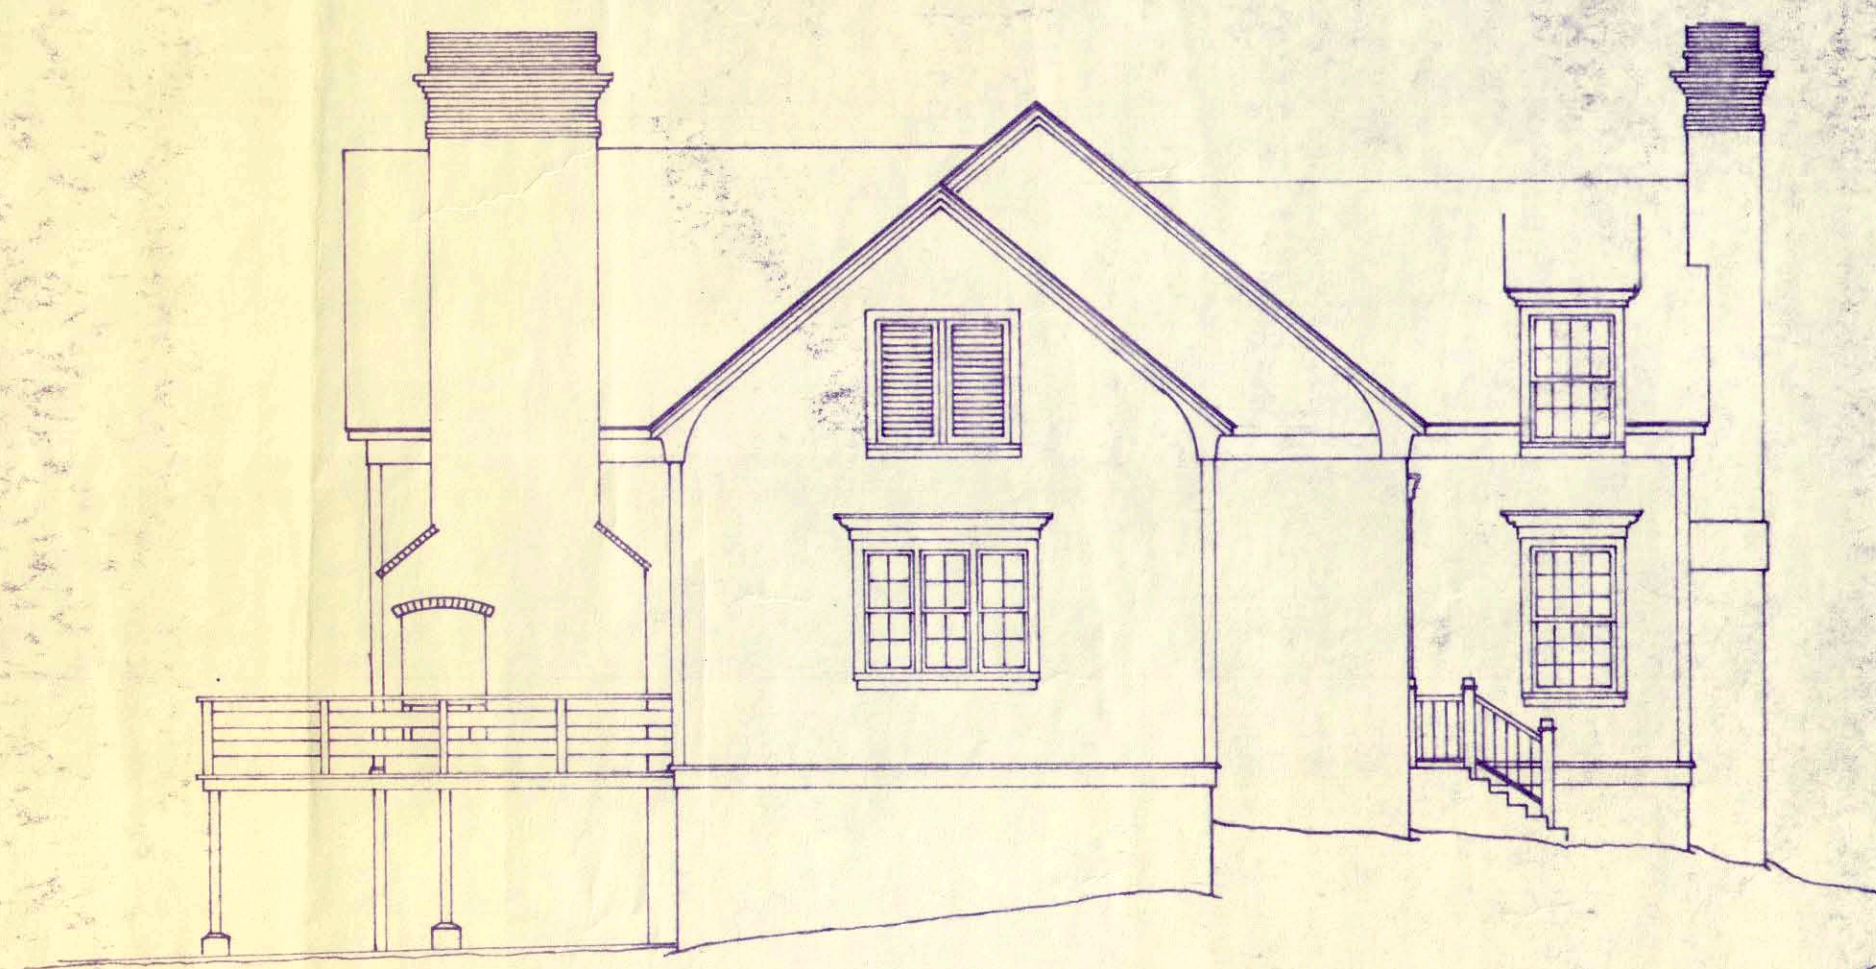

LEFT



REAR



RIGHT




FRONT

BARRETT "SHADOW BLACK"
245# COMP. SHINGLE. LAY
FROM LEFT TO RIGHT.

ELEVATIONS

key	qty	botanical name	common name	size	sp	remarks
BD	1	Betula nigra	Paper Birch	2 1/2-3" cal		multi trunk
MS	3	Magnolia stellata	Star Magnolia	5-6'		
IO	7	Ilex opaca 'Savannah'	Savannah Holly	4-5'		tree-form
RH	6	Rhododendron hybrida	Red Rhododendron	3 gal	40"	
PL	50	Prunus laurocerasus	Otto Luyken Laurel	3 gal	36"	
IC	23	Ilex cornuta 'Needlepoint'	Needlepoint Holly	3 gal	36"	
IV	13	Ilex vomitoria 'nana'	Dwarf Yaupon Holly	1 gal	30"	
IH	14	Ilex opaca 'Golden Yeller'	Golden Yeller Holly	1 gal	30"	
AHG	18	Azalea hybrida 'Gumpo'	Gumpo White Azalea	1 gal	30"	
AHW	44	Azalea hybrida 'Wakaebisu'	Wakaebisu Red Azalea	1 gal	30"	
AHD	16	Azalea hybrida 'Delaware Valley White'	Delaware Valley Azalea	1 gal	30"	
SR	9	Spiraea cantoniensis	Reeves Spiraea	1 gal	30"	
LV	14	Ligustrum vicaryi	Variegated Ligustrum	3 gal	42"	
FI	4	Forsythia intermedia	Forsythia	5 gal	48"	
RA	2	Rosa hybrida	Red Rose (CLIMBING)	1 gal		to fill in on fence
VM	205	Vinca minor	Perrinwinkle	BR	12"	
HH	182	Hedera helix	English Ivy	1 gal	12"	
LMV	141	Liriope muscarii 'Variegated'	Variegated Liriope	1 gal	12"	
LM	90	Liriope muscarii	Lily-Turf	1 gal	12"	
DL	20	Heimeracallis hybrida	Yellow Daylily	1 gal	24"	
SC	134	Seasonal color		5" pots	18"	
		Secunda Sod 2000 sq ft	MEYER ZOTZIA			
		6000 sq ft Mulch - 150 Bales	Pineneedles			

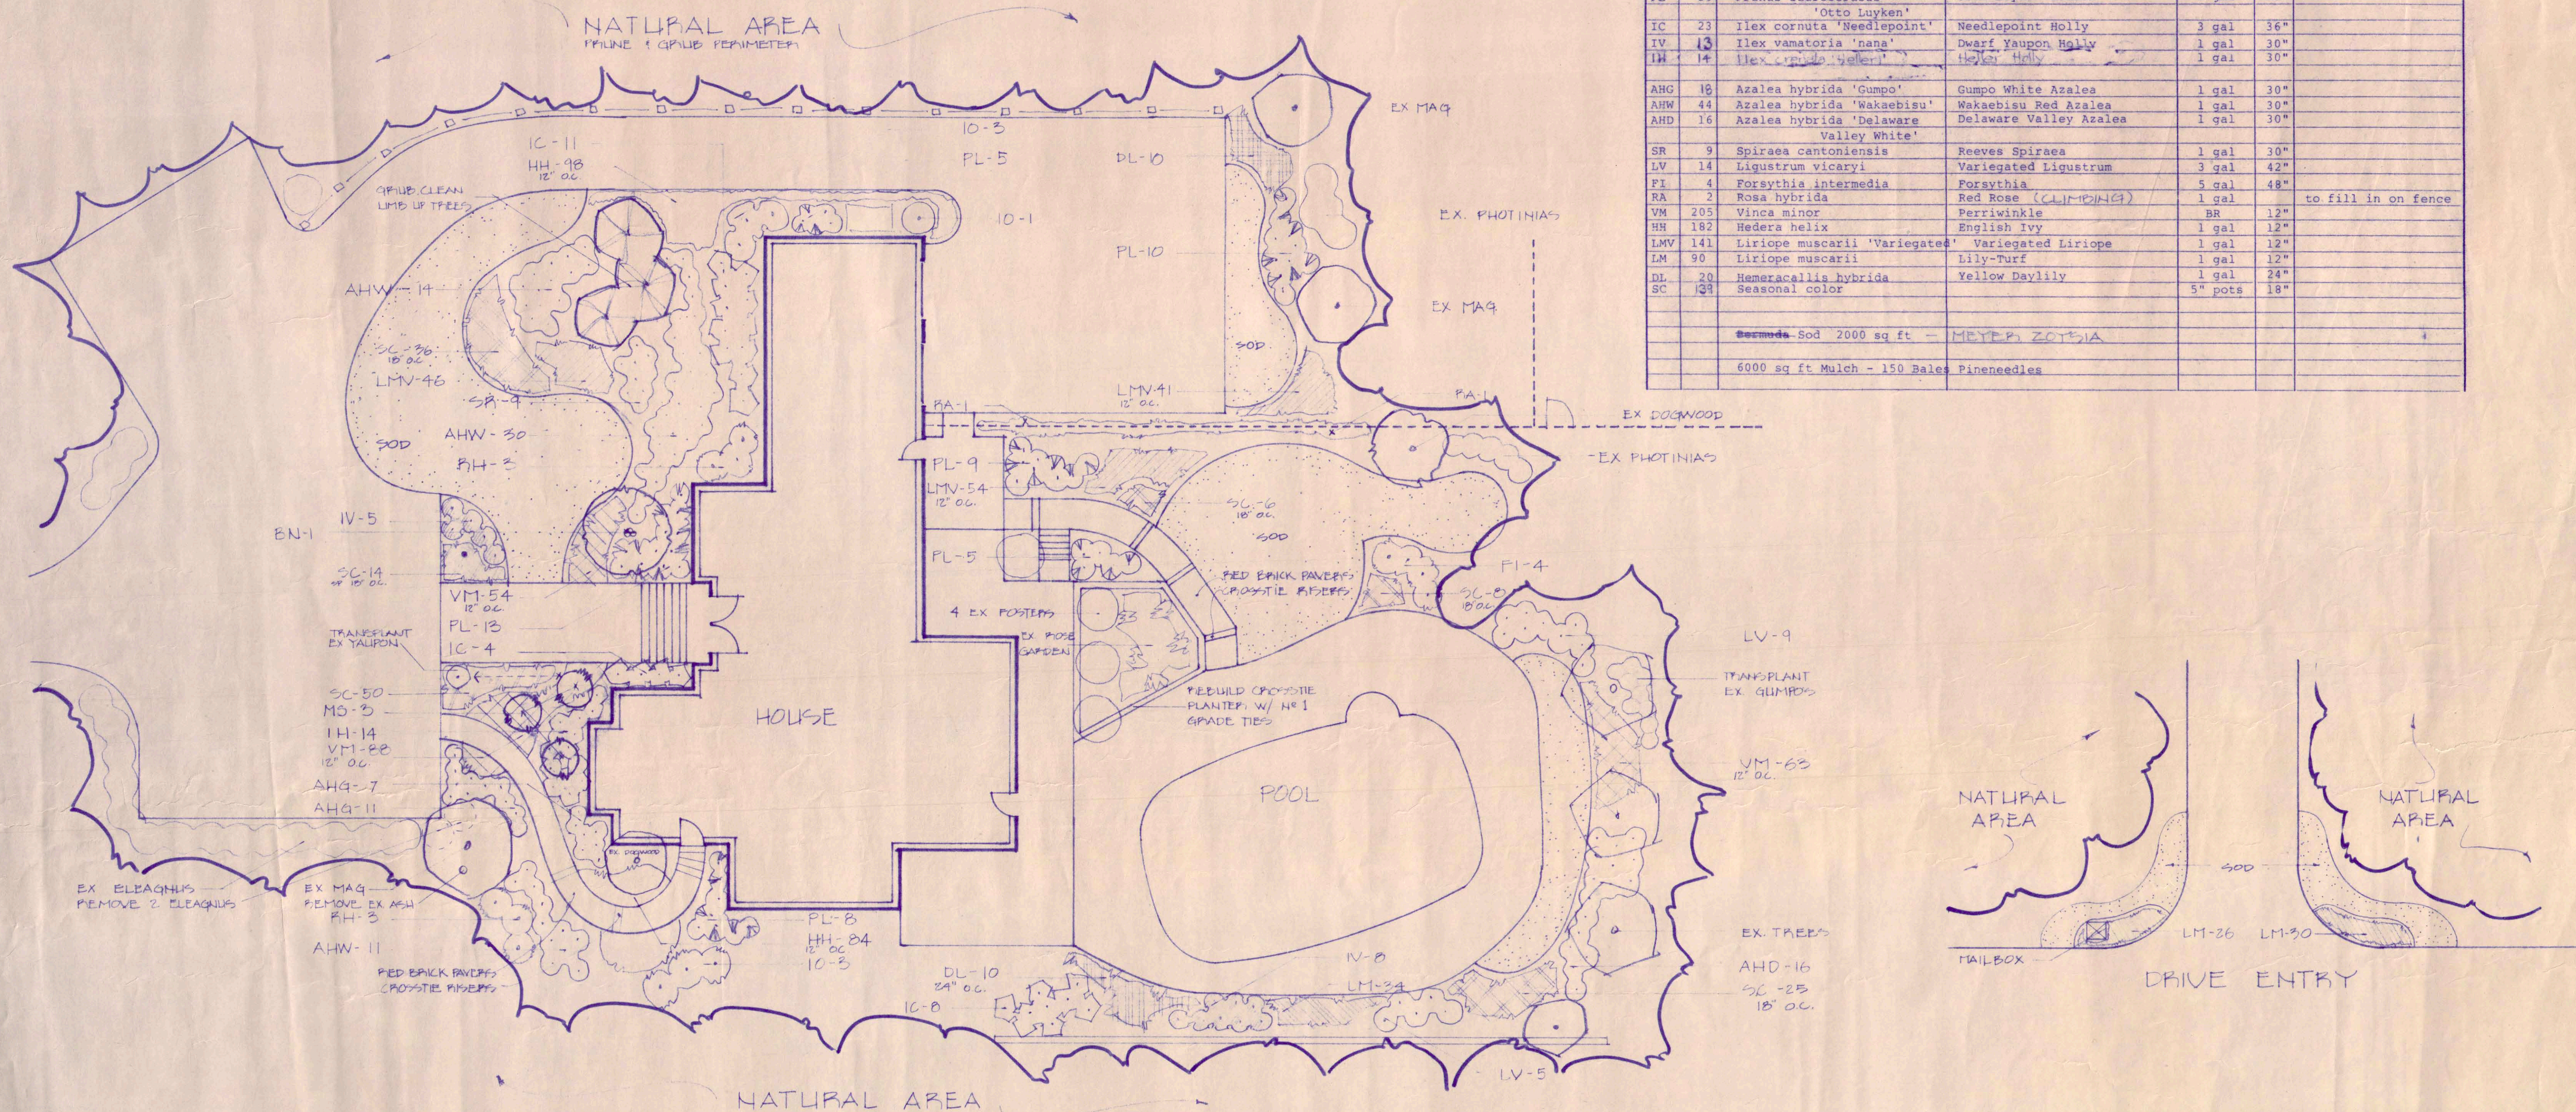


LANDSCAPE PLANTING PLAN

Custom | Landscape Contractors




1550 Terrell Mill Road 4-F
Atlanta • Georgia • 30067
Telephone: (404) 956-9523

DESIGNERS CONTRACTORS CONSULTANTS

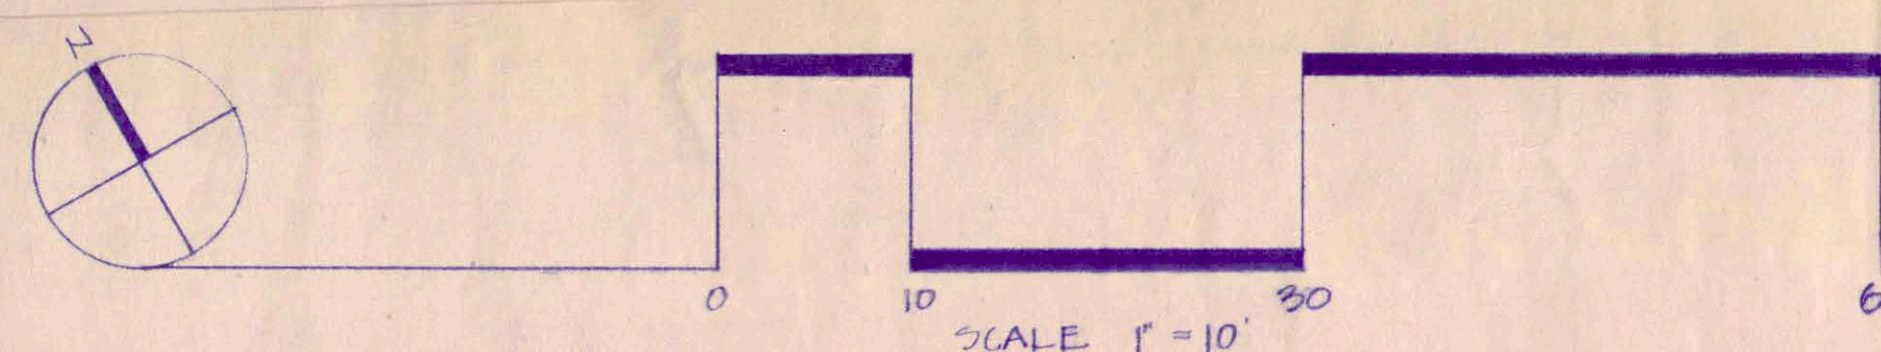

PLANT LIST

key	qty	botanical name	common name	size	sp	remarks
BN	1	Betula nigra	Flowering Birch	2 1/2-3' cal		multi trunk
MS	3	Magnolia stellata	Star Magnolia	5-6'		
IO	7	Ilex opaca 'Savannah'	Savannah Holly	4-5'		tree-form
RH	6	Rhododendron hybrida	Red Rhododendron	3 gal	40"	
PL	50	Prunus laurocerasus	Otto Luyken Laurel	3 gal	36"	
IC	23	Ilex cornuta 'Needlepoint'	Needlepoint Holly	3 gal	36"	
IV	13	Ilex vomitoria 'nana'	Dwarf Yaupon Holly	1 gal	30"	
IH	14	Ilex cornuta 'Golden'	Holly Holly	1 gal	30"	
AHG	18	Azalea hybrida 'Gumpo'	Gumpo White Azalea	1 gal	30"	
AHW	44	Azalea hybrida 'Wakaebisu'	Wakaebisu Red Azalea	1 gal	30"	
AHD	16	Azalea hybrida 'Delaware Valley White'	Delaware Valley Azalea	1 gal	30"	
SR	9	Spiraea cantoniensis	Reeves Spiraea	1 gal	30"	
LV	14	Ligustrum vicaryi	Variegated Ligustrum	3 gal	42"	
FI	4	Forsythia intermedia	Forsythia	5 gal	48"	
RA	2	Rosa hybrida	Red Rose (CLIMBING)	1 gal		to fill in on fence
VM	205	Vinca minor	Periwinkle	BR	12"	
HH	182	Hedera helix	English Ivy	1 gal	12"	
LMV	141	Liriope muscarii 'Variegated'	Variegated Liriope	1 gal	12"	
LM	90	Liriope muscarii	Lily-Turf	1 gal	12"	
DL	20	Hemerocallis hybrida	Yellow Daylily	1 gal	24"	
SC	139	Seasonal color		5" pots	18"	
		Scrumdo Sod 2000 sq ft	MEYER ZOTSLA			
		6000 sq ft Mulch - 150 Bales	Pineneedles			

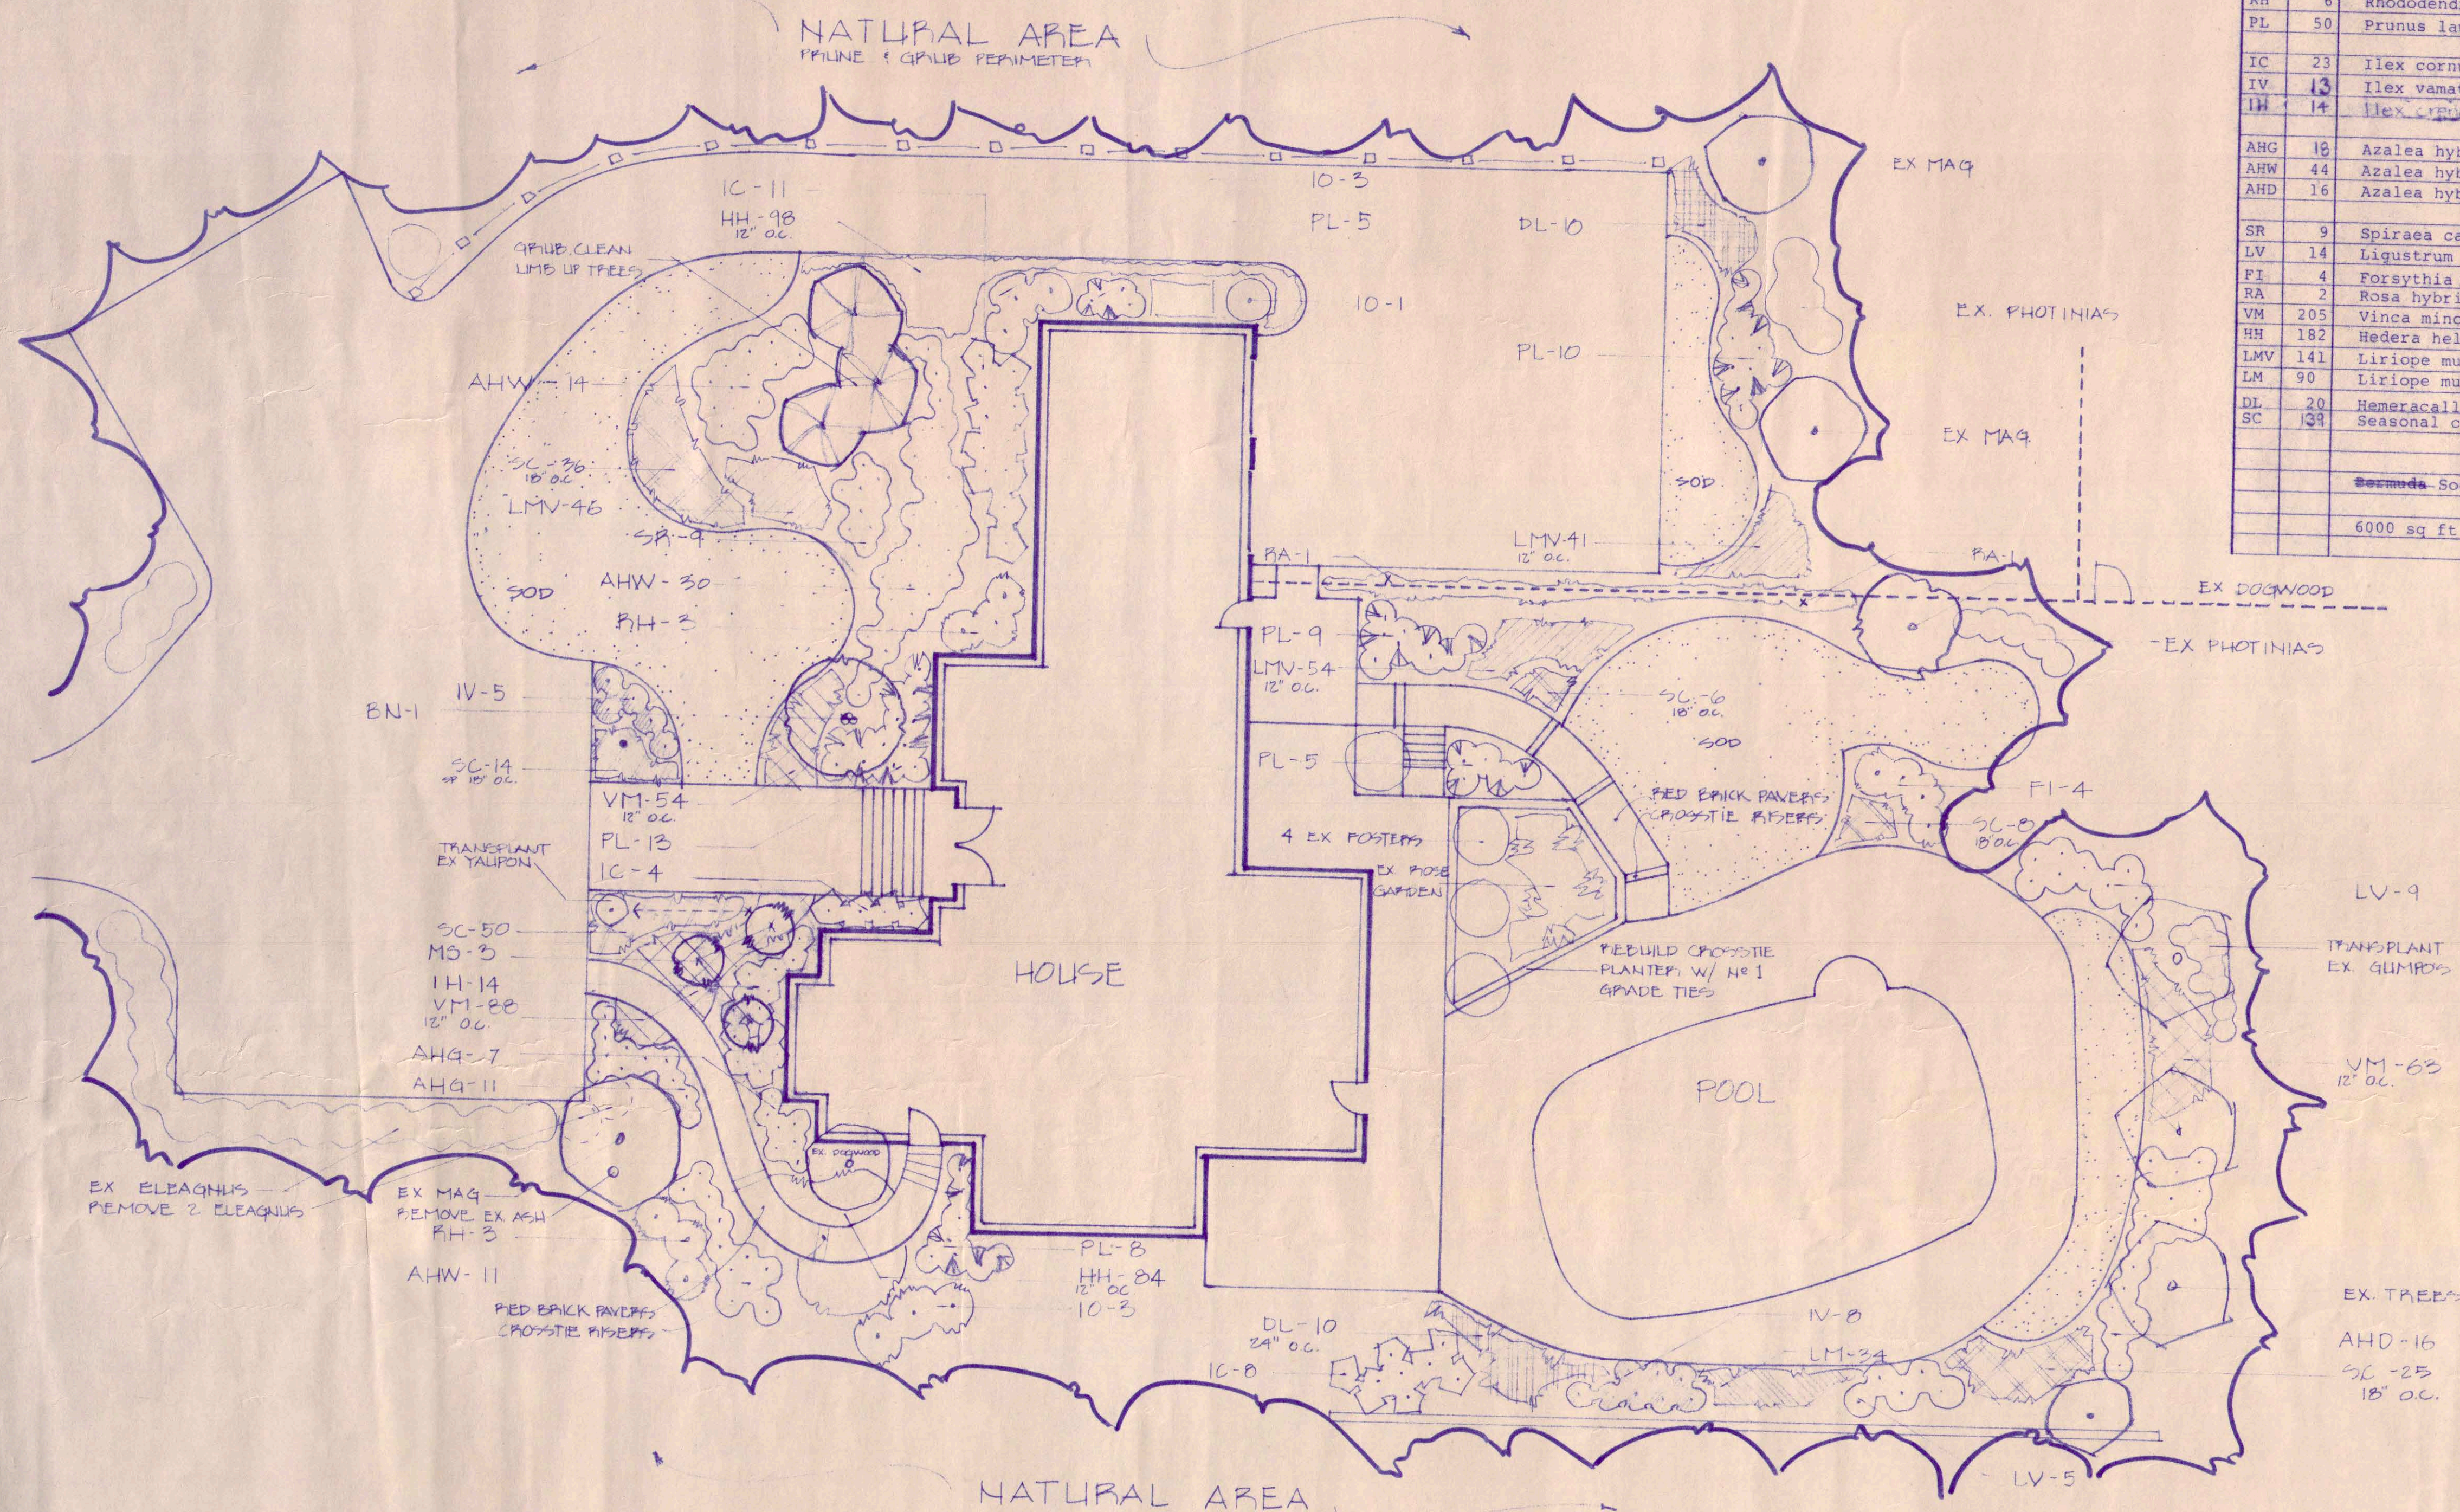

CANTRE
LANDSC
Custo
DESIG

